
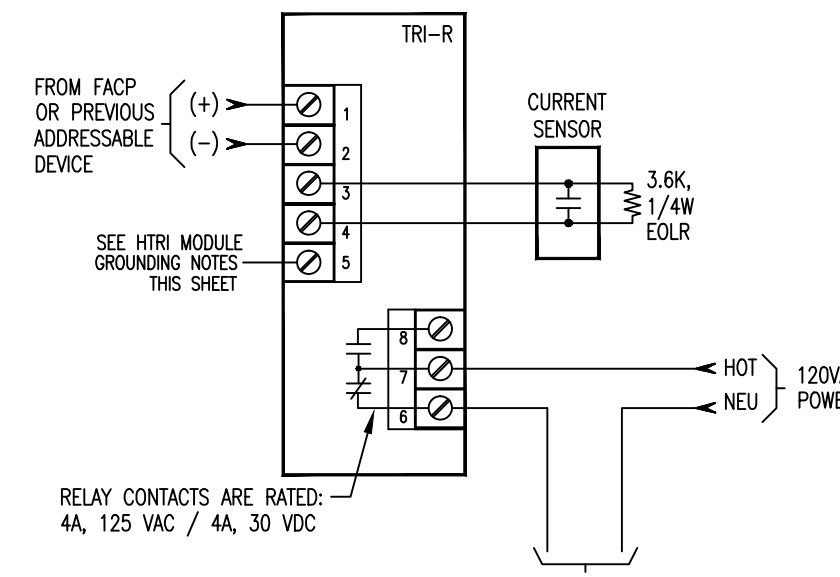
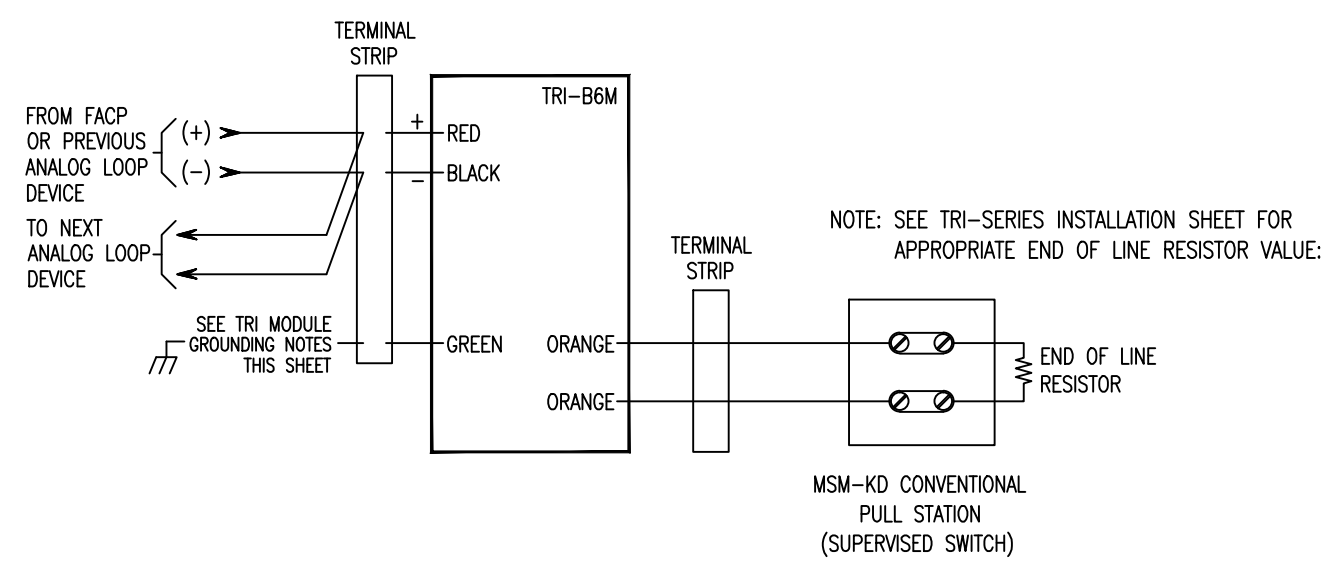




TYPICAL WIRING OF FIELD DEVICES

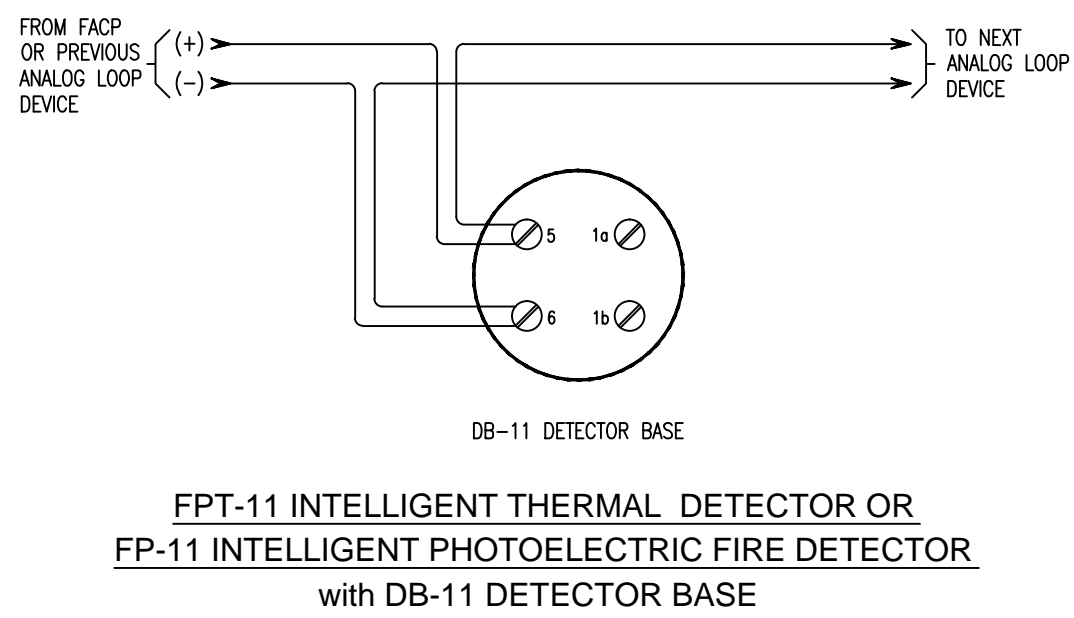

TRI-S/TRI-R/TRI-D/TRI-M GROUNDING NOTES

1. CAUTION: GROUND SHIELD ONLY AT THE SPECIFIED LOCATION ON THE CONTROL PANEL.  
REFER TO INSTALLATION INSTRUCTIONS PIN 315-08242-2 FOR FURTHER DETAILS

TYPICAL TRI MODULE GROUNDING DETAIL

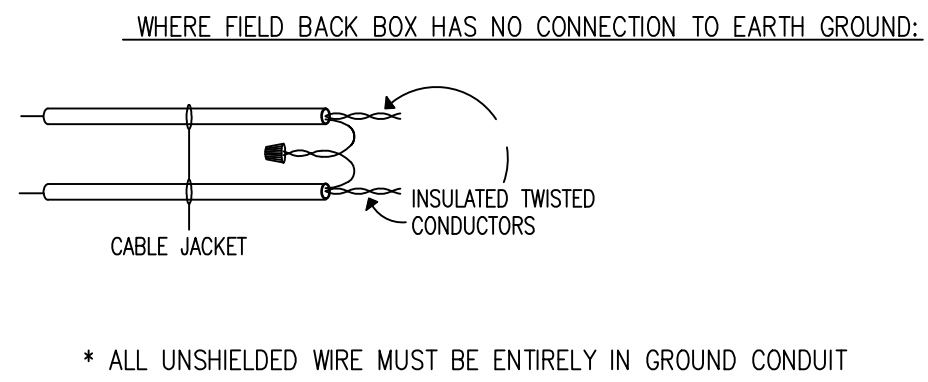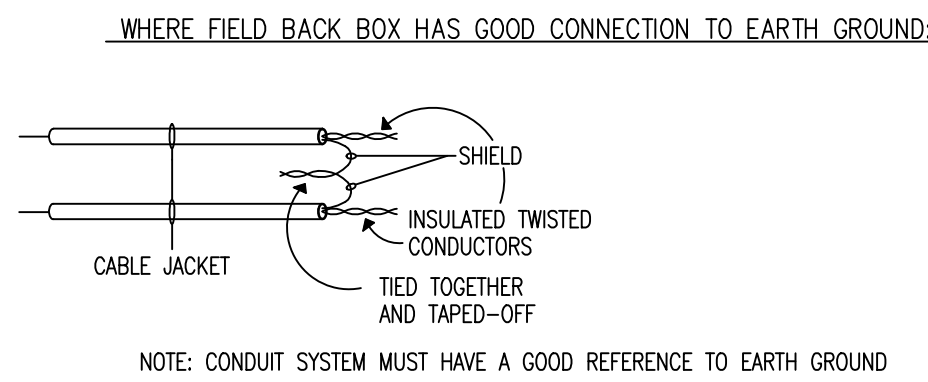


REVISIONS

No.	Revision	By	Date	App.
1	REVISED PER FIRE MARSHAL'S COMMENTS (DATED 02/12/09)	JPM	2/27/09	KW
2	AS-BUILT	JPM	8/10/09	KW

AS BUILT

C-10 APPROVAL STAMP:

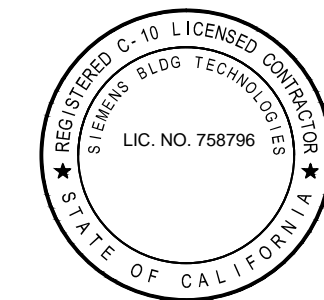

ENGINEERING CONSULTANTS:

CUSTOMER'S NAME & ADDRESS

PRODUCT MANUFACTURER:

Siemens Building Technologies, Inc.  
Fire Safety Division  
25221 Industrial Boulevard, Suite 300  
Hayward, California 94545-2991  
Tel (510) 783-6000 Fax (510) 293-2100  
California State C10 License No. 758796  
U.L. Certificate ID No. 324787-001

JOB NAME & LOCATION (STREET ADDRESS)

LAWRENCE BERKELEY  
NATIONAL LABORATORY

BERKELEY LAB  
GUEST HOUSE

Berkeley, California

SHEET CONTENTS:

TYPICAL WIRING  
OF FIELD DEVICES

INSTALLATION TYPE

- ☐ NEW INSTALLATION  
☐ DESIGN/BUILD  
☐ PER CONTRACT DOCUMENT  
☐ EXISTING BASE JOB # N/A  
☐ OTHERS

SYSTEM SALES REP.: Kevin Waxman

PROJECT MANAGER: Mark Milard

DRAWN BY: John Paul Minas

CAD FILENAME: FA-06

SCALE: Not Applicable

DATE DRAWN: January 12, 2009 PLOT DATE: November 04, 2013

SHEET: FA-06 JOB NUMBER: 440P-048653

DRAWING NO.  
6B23E008

IF DRAWING IS SMALLER THAN 30" X 42" IT IS A REDUCED COPY